


FIRST FLOOR AS BUILT PLAN

SCALE:  $\frac{1}{8}'' = 1' - 0''$

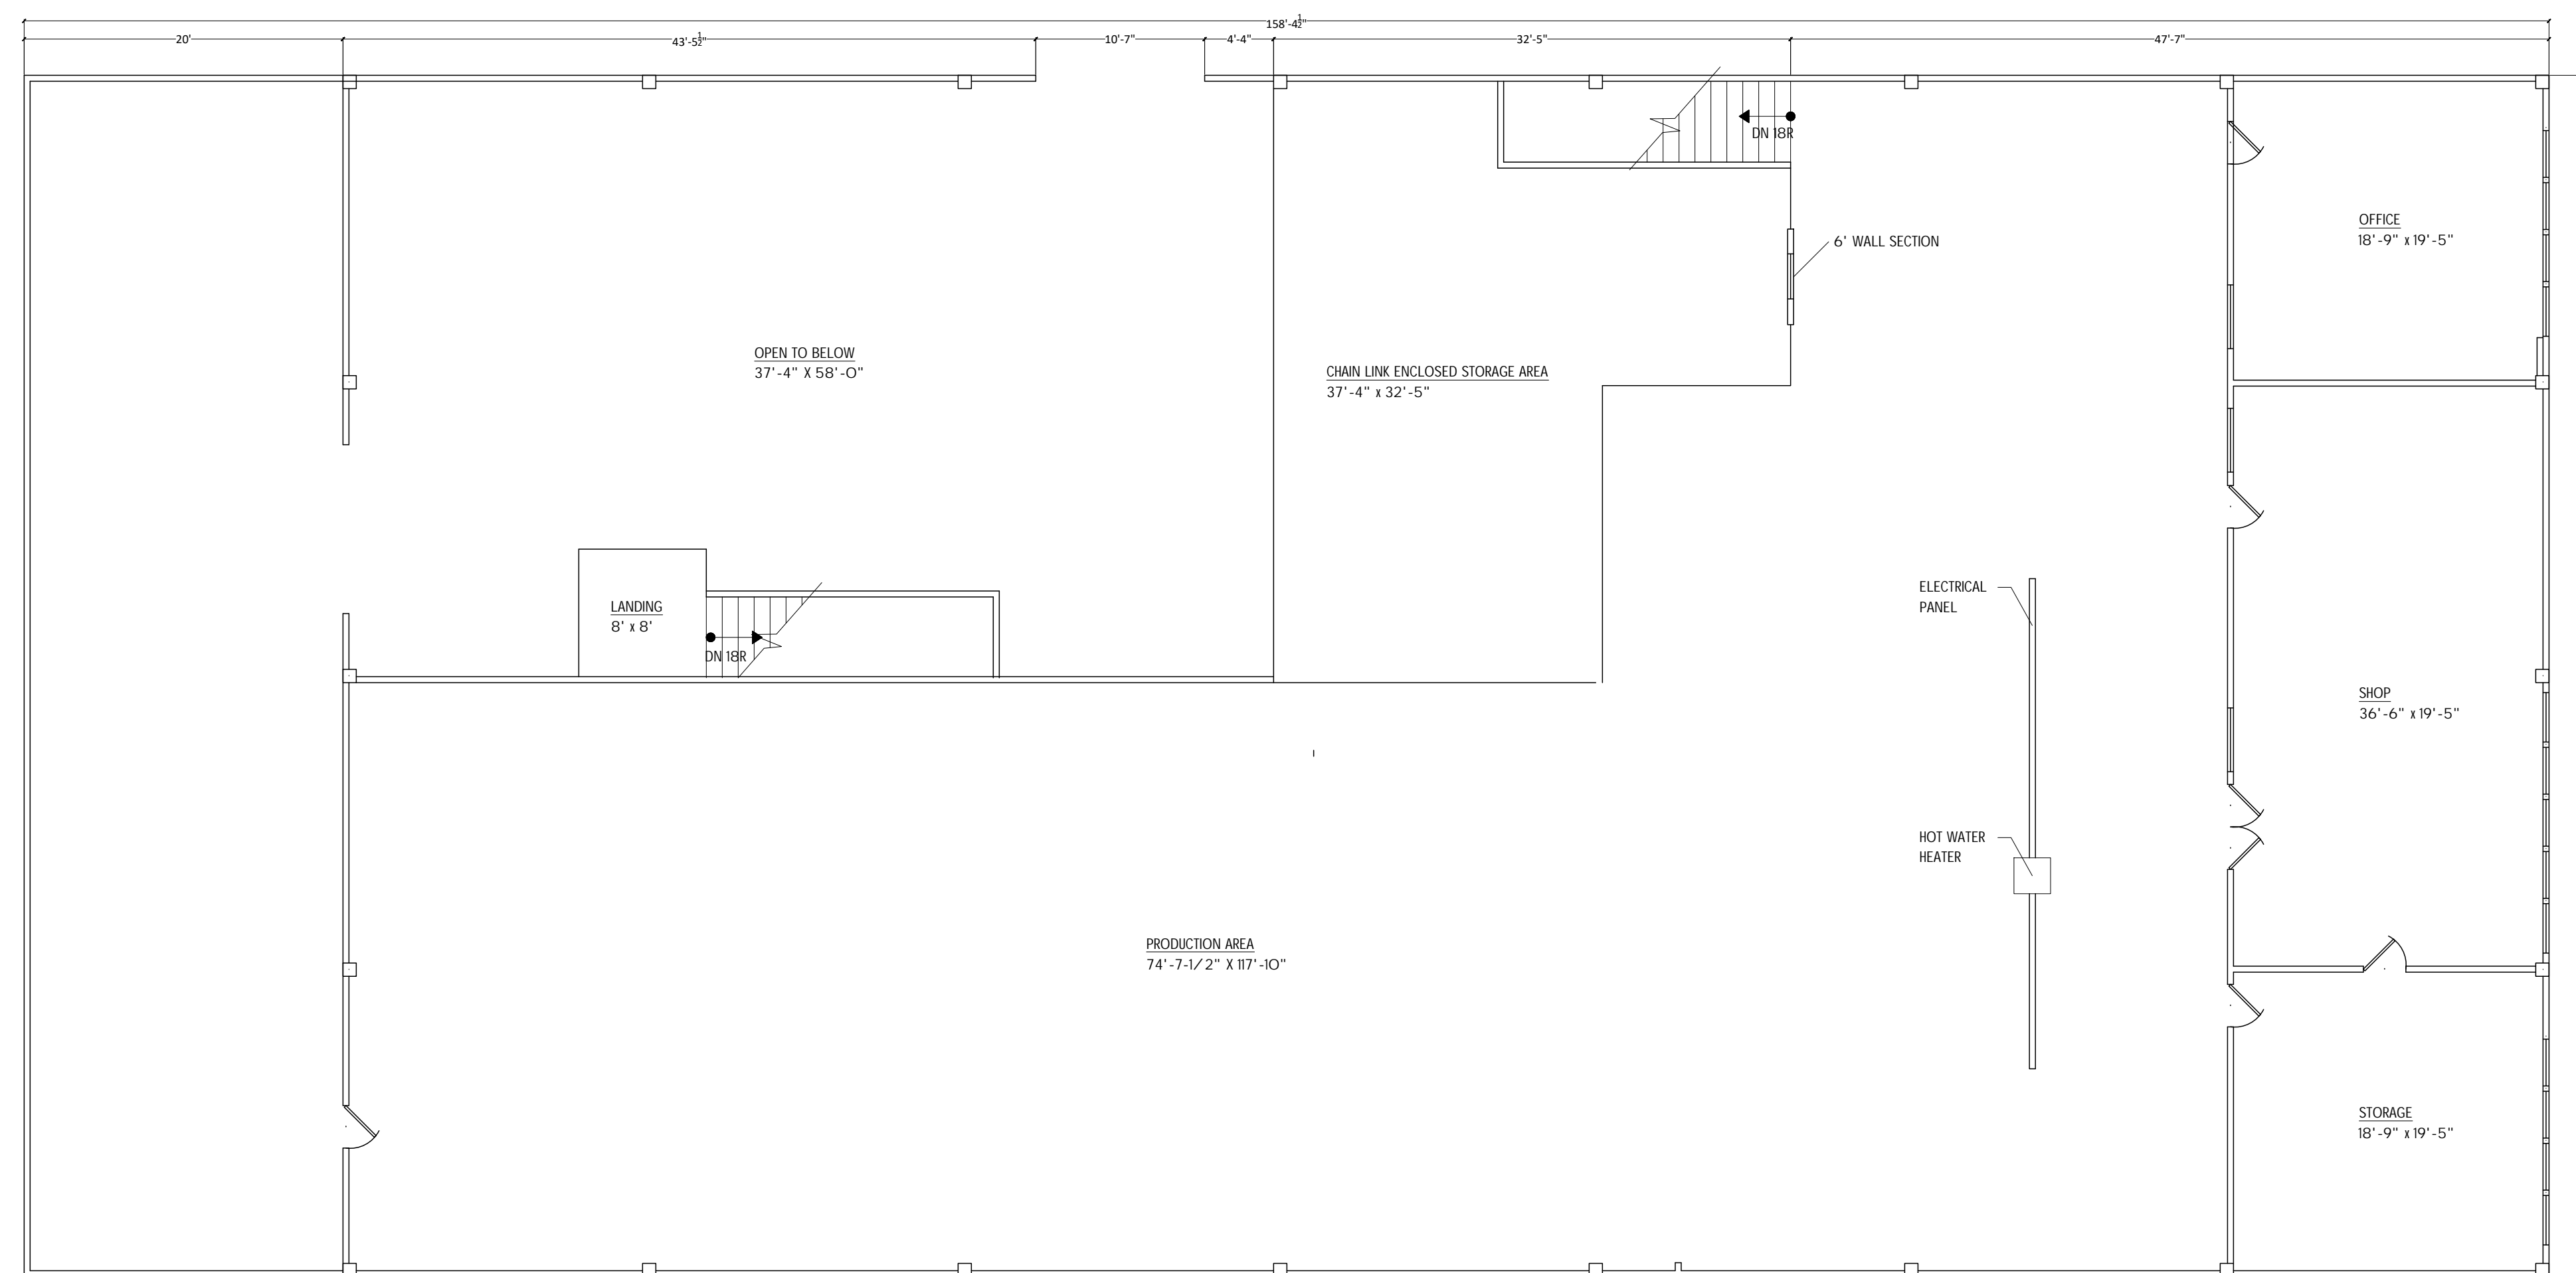

SECOND FLOOR AS BUILT PLAN

SCALE:  $\frac{1}{8}'' = 1' - 0''$

ALL ERRORS, OMISSIONS, OR CONFLICTS BETWEEN THE VARIOUS ELEMENTS OF THE WORKING DRAWINGS SHALL BE IMMEDIATELY BROUGHT TO THE ATTENTION OF THE DESIGNER AND CONTRACTOR FOR CLARIFICATION OR CORRECTION. IF NOTIFICATION IS NOT MADE AND WORK IS CONTINUED, RESPONSIBILITY FOR ANY FUTURE PROBLEMS CREATED WILL BE BORNE BY THE CONTRACTOR OR SUBCONTRACTOR INVOLVED.

**COMMERCIAL REMODEL**  
962 KAISER ROAD, NAPA, CALIFORNIA

REVISIONS:  
DRAWN: EW 8/30/19  
R1:  
R2:  
R3:  
R4:

PAGE  
**A1**